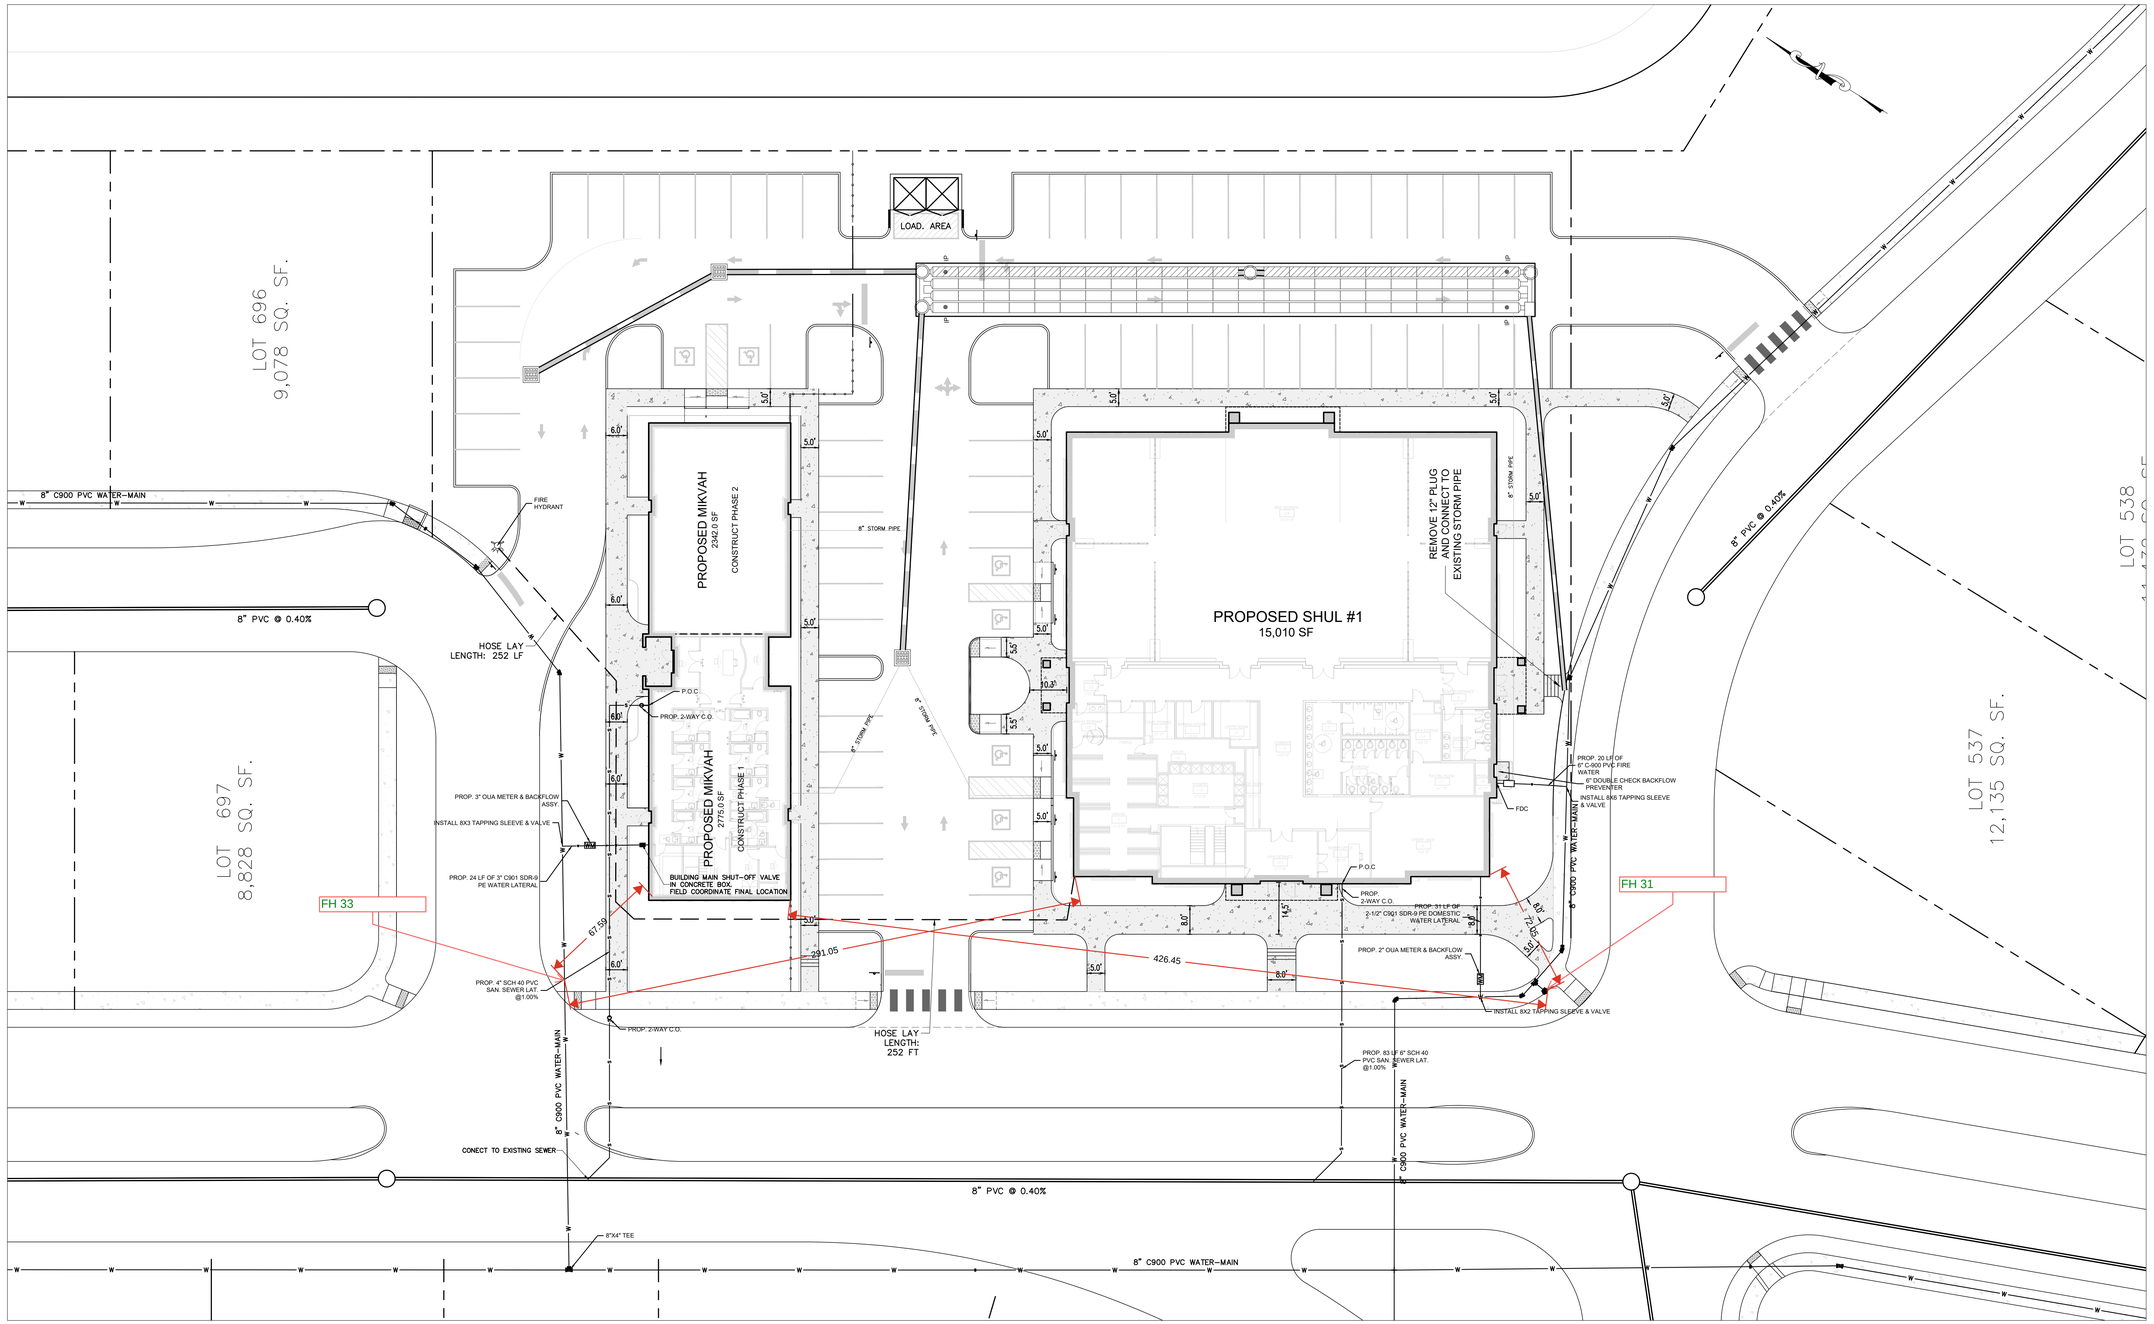


LEGEND:

- PROPOSED FIRE HYDRANT
- PROPOSED SANITARY CLEANOUT
- PROPOSED SANITARY MANHOLE
- PROPOSED SANITARY LATERAL
- PROPOSED SANITARY LATERAL
- EXISTING SANITARY LATERAL OR MAIN
- PROPOSED WATER METER
- PROPOSED WATER LATERAL OR MAIN
- EXISTING WATER LATERAL OR MAIN

GRAPHIC SCALE

20 0 10 20 40 80

(IN FEET)

1 inch = 20 ft.

NOTES:

1. LOCATIONS OF UTILITIES ARE APPROXIMATE ONLY. CONTRACTOR TO FIELD VERIFY LOCATIONS OF ALL EXISTING OR PROPOSED UTILITIES WITH MOST UPDATED CONSTRUCTION DOCUMENTS. CONTRACTOR IS TO FAMILIARIZE HIMSELF WITH, AND VERIFY CONDITIONS AT SITE.
2. CONTRACTOR SHALL MAKE DILIGENT INQUIRY AT THE OFFICE OF THE UTILITY COMPANIES AND MUNICIPAL AUTHORITIES TO DETERMINE THE EXACT LOCATION OF UTILITY STRUCTURES.
3. THE CONTRACTOR SHALL NOTIFY, IN WRITING, THE UTILITY COMPANIES, MUNICIPALITY AND OWNERS INVOLVED OF THE NATURE AND SCOPE OF THE PROJECT, AND OF HIS OPERATIONS THAT AFFECT THEIR FACILITIES OF PROPERTY.
4. UNLESS OTHERWISE NOTED THE CONTRACTOR IS RESPONSIBLE FOR TEMPORARY DE-WATERING OF STRUCTURES, SEWER LINE, DRAINAGE PIPE AND WATER LINES.

CALL 48 HOURS BEFORE YOU DIG IN FLORIDA, IT'S THE LAW

Sunshine State One Call of Florida, Inc. 811

THIS DOCUMENT, TOGETHER WITH THE CONCEPTS AND DESIGNS PRESENTED HEREIN, AS AN INSTRUMENT OF SERVICE, IS INTENDED ONLY FOR THE SPECIFIC PURPOSE AND CLIENT FOR WHICH IT WAS PREPARED. REUSE OF AND IMPROPER RELIANCE ON THIS DOCUMENT WITHOUT WRITTEN AUTHORIZATION AND ADOPTION BY STEVEN L. DOBBS, P.E., SHALL BE WITHOUT LIABILITY TO NEWLINES ENGINEERING & SURVEY AND STEVEN L. DOBBS ENGINEERING, LLC.

UTILITY PLAN

PHASE 1 - 1.1 SHUL #1 & MIKVAH

LYING IN SEC 35, TOWNSHIP 38 SOUTH, RANGE 34, GLADES COUNTY, FLORIDA

NEWLINES LAND CONSULTANTS

STEVEN L. DOBBS, P.E.

FLORIDA CERTIFICATE OF AUTHORIZATION NO. 00029206

STEVEN L. DOBBS ENGINEERING, LLC

1062 JAKES WAY OKEECHOBEE, FL 34974, PHONE (863) 824-7644

PROJECT No.	21534
DRAWN BY	YB/MB
SCALE	1" = 20'
DATE	7/1/2024
SHEET No.	5 OF 15